



CITY OF ST PAUL
Department of Public Works
25 West 4th Street
1500 City Hall Annex
Saint Paul, MN 55102

ORDINANCE PERMIT

OFFICE USE ONLY

Application No. 1
Application Date 5/25/22
SPR File # 21-281743
Permit No. 20223460401

Type of Permit (select one only):

- | | | |
|---|---|--|
| ☐ 01 Roadway | ☒ 04 Storm Sewer Collection | ☐ 07 Sanitary Sewer Special |
| ☐ 02 Sidewalk | ☐ 05 Storm Sewer Treatment | ☐ 08 Retaining Wall |
| ☐ 03 Traffic Appurtenances | ☐ 06 Sanitary Sewer Collection | ☐ 09 Bridge |

Phase:

2022
Johnny Opara - Developer

Location (Street On, From/To, and Adjacent Lots/Blocks):

520 Payne Ave. From the Woodward and Payne intersection proceeding North on Payne to the utility impacted area (approximately 50 ft).

Description of Work: [Include the description provided in the permit application and all subsequent amendments or revisions, which are hereby incorporated by reference.]

Install two storm manholes and City storm main in Payne Ave. Due to the road being paved within 5 years, a full curb to curb mill and overlay from Woodward and Payne intersection North on Payne to the utility impacted area in Payne Ave. Striping to match existing to follow the mill and overlay.

Applicant Contact Person:

Cory Craig- Doran Co

Contact Person Title:

Project Engineer

Contact Person Telephone:

763.360.2194

Contact Person Email:

cory.craig@dorancompanies.com

Bond Co.:

Berkshire Hathaway Specialty Insurance Company

Bond Amount:

\$52,200

Bond No.:

47-SUR-300210-01-0008

Insurance Co.:

Citizens Insurance Company of America

Insurance Certificate No.:

480143187

Permit Conditions:

Contractor to submit post-construction videos of new public sewers and manholes to Engineer of Record and Sewer Utility for review

This permit is issued with the stipulation that the work of the permittee and related agents, employees and contractors shall conform in all respects to the City of Saint Paul Department of Public Works Ordinance Permit Process Document and the Department of Public Works List of Applicable Standards & Specifications. The permit shall be available for display at the site referred to herein and shown to any Police Officer or Inspector upon demand and does not authorize or allow for interference with the work of any Contract made or to be made with the City of Saint Paul.

**THIS PERMIT MAY BE REVOKED AT ANY TIME
BY THE DIRECTOR OF PUBLIC WORKS**

A PERMIT FOR THE ABOVE DESCRIBED CONSTRUCTION IS AUTHORIZED BY:


Signature

Assistant City Engineer

Title


6-9-2022
Date

Nick Peterson

Printed Name

PERMIT NUMBER 20223460401

K:\016817-000\CadPlan\016817-000-C-UTIL-PLAN.dwg 9/1/2022 4:03:04 PM

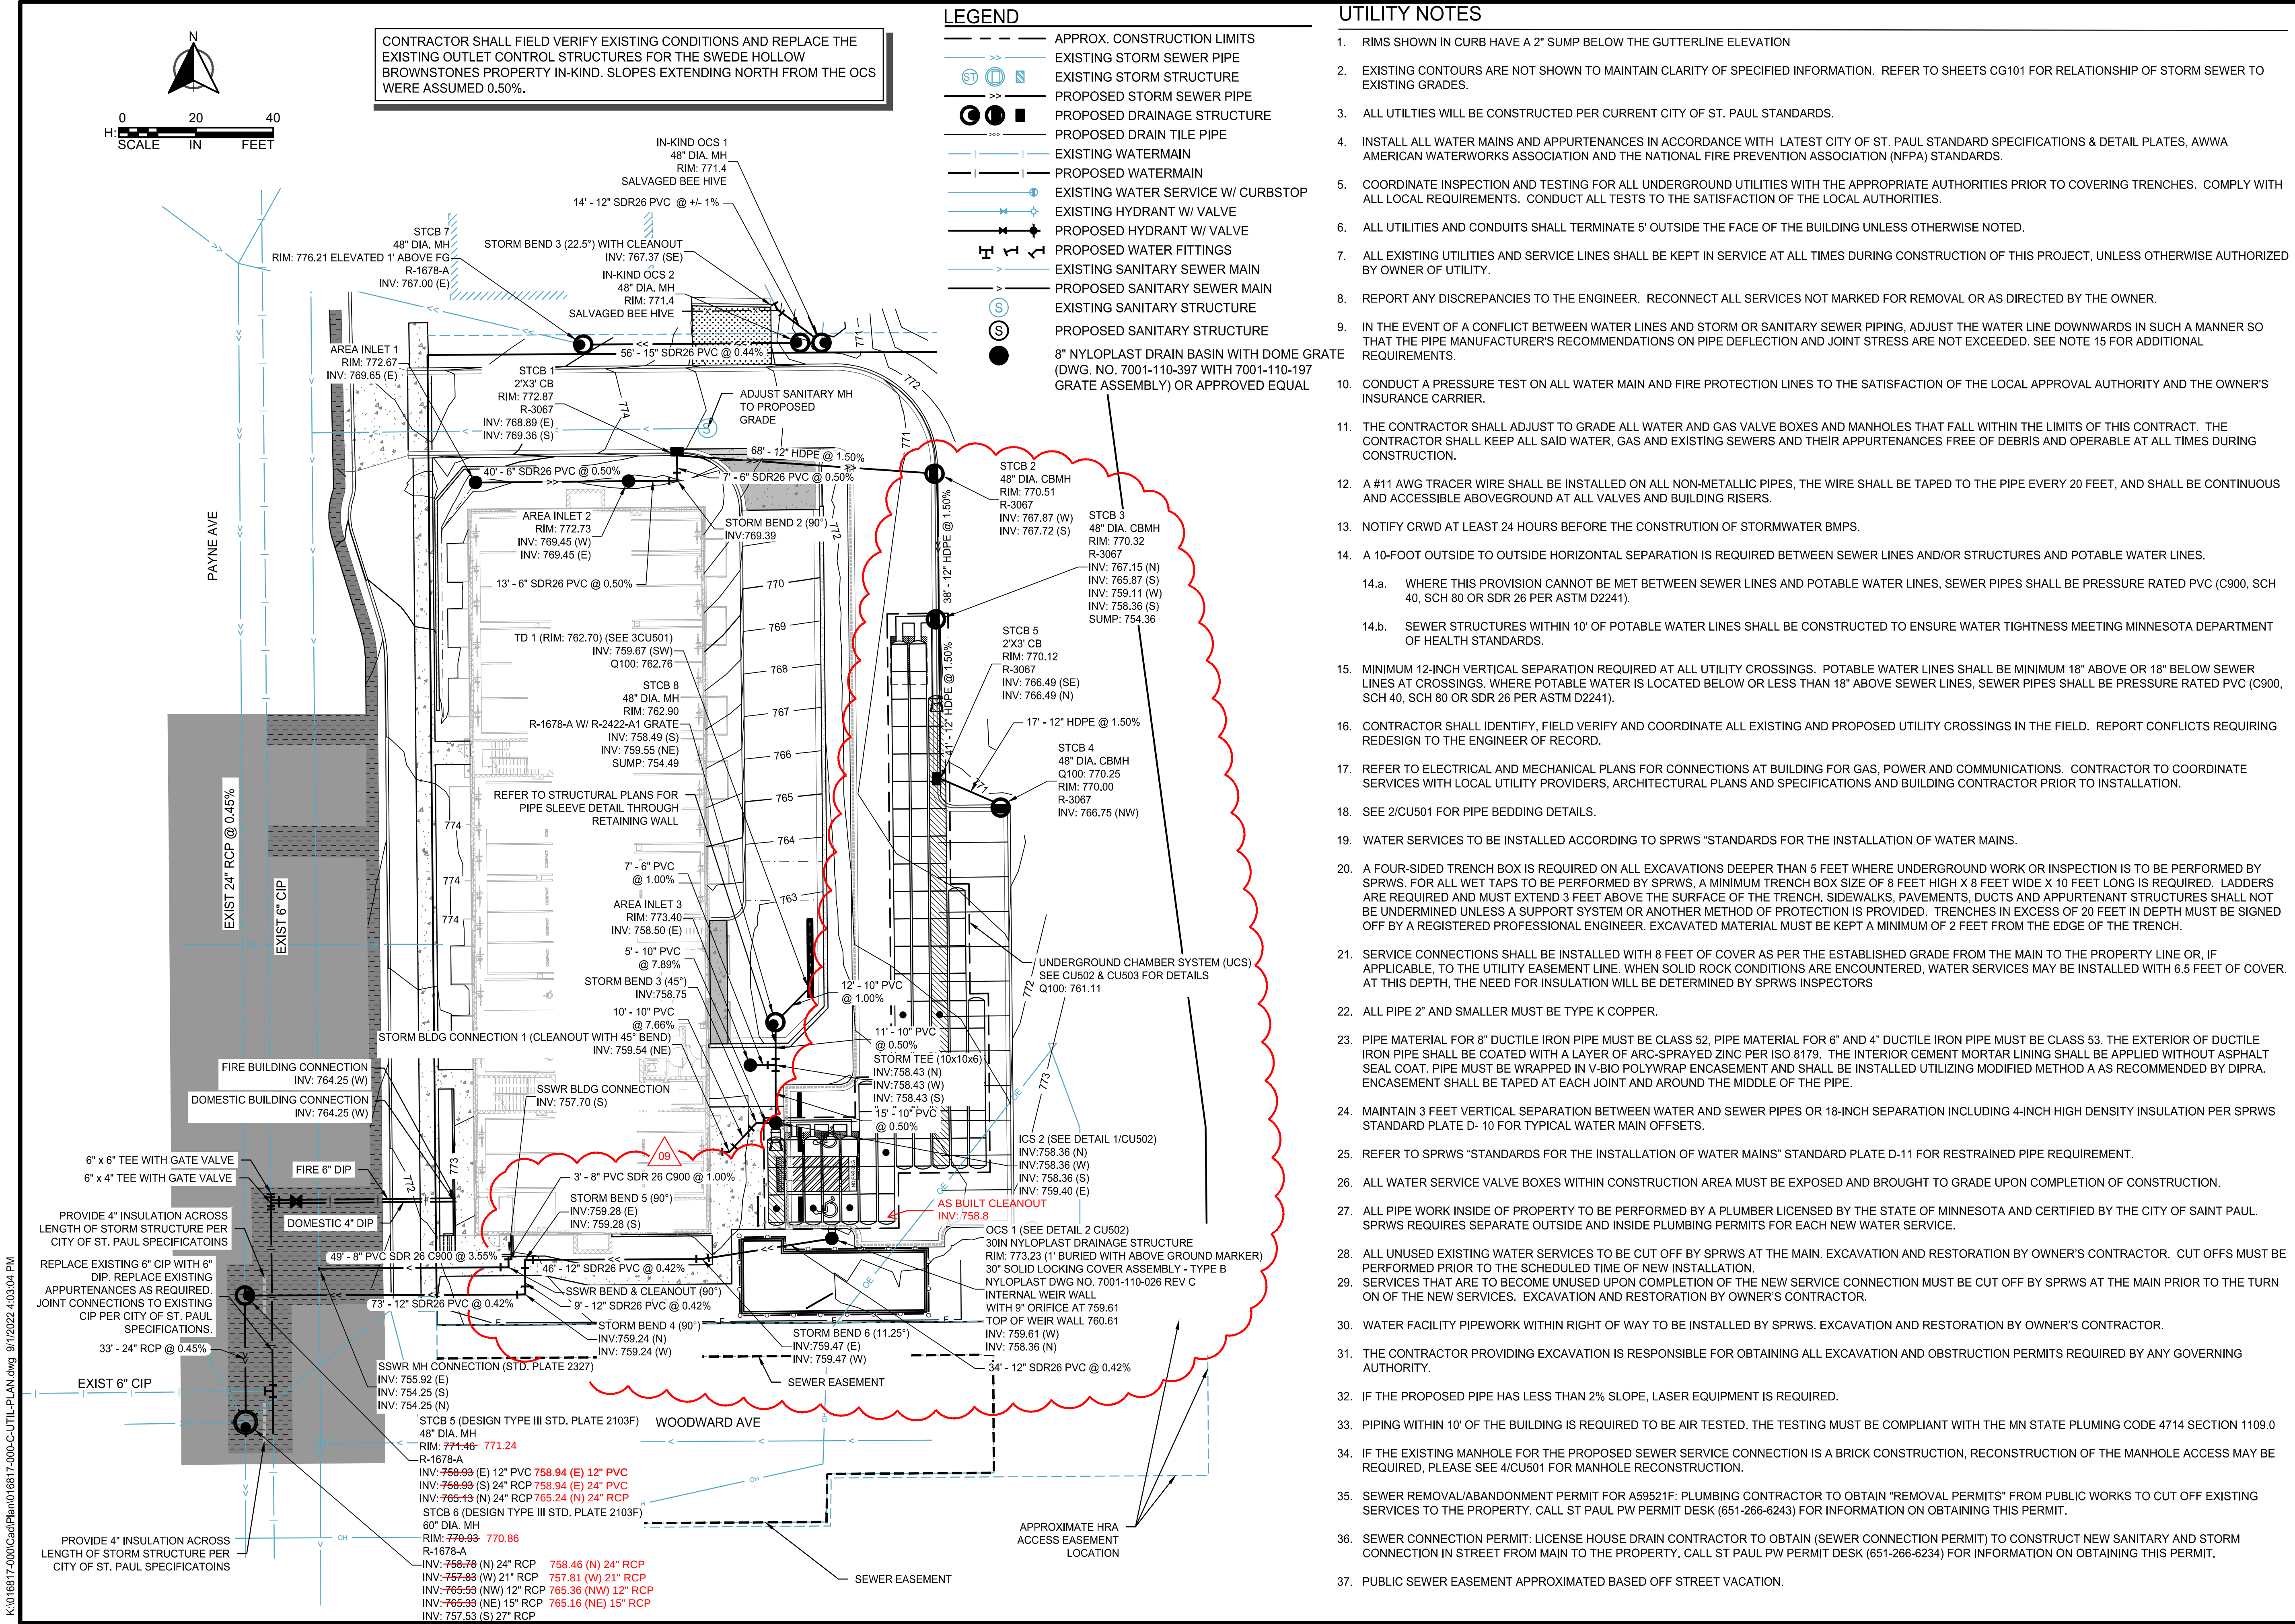

SCALE: AS SHOWN
DESIGN BY: TOR
PLAN BY: CHECK BY: CLB
TOR

REVISIONS		WATERSHED APPROVAL
NO.	DATE	DESCRIPTION
05	12/17/2021	CS1-01
06	01/20/2022	CS1-02
07	04/25/2022	CS1-03
08	06/30/2022	CS1-04
09	09/01/2022	CS1-05

I HEREBY CERTIFY THAT THIS PLAN, SPECIFICATION, OR REPORT WAS PREPARED BY ME OR UNDER MY DIRECT SUPERVISION AND THAT I AM A DULY LICENSED PROFESSIONAL ENGINEER UNDER THE LAWS OF THE STATE OF MINNESOTA.

Taylor O. Rumph
TAYLOR O. RUMPH
DATE: 09/01/2022 LIC. NO.: 59663

UTILITY PLAN
ISSUED FOR
RECORD DRAWING

THE HOLLOWES
520 PAYNE AVE ST. PAUL, MINNESOTA

WSB PROJECT NO.
016817-000

SHEET
CU101